

NOTE: ENTIRE POST ASSEMBLY TO BE GALVANIZED AND PAINTED TO MATCH P-1 - SEE SPECS

THE ORIGINAL DRAWING WAS STAMPED BY RUSSELL K HANSON OREGON R.A.

FENCE
1 1/2" = 1'-0"

28

NOTE: SEE STRUCT FOR FOOTING SIZES AND DEPTHS

FENCE / SIDEWALK
1 1/2" = 1'-0"

29

RECORD DRAWINGS

THIS RECORD DRAWING HAS BEEN PREPARED IN PART FROM THE BASIS OF INFORMATION OBTAINED BY OTHERS. THE TYPE OF INFORMATION OBTAINED FROM OTHERS IS NOT GUARANTEED AND WILL NOT BE RESPONSIBLE FOR ANY ERRORS OR OMISSIONS IN THIS RECORD DRAWING.


THRU ROOF OPENING
3" = 1'-0"

32


ATTACH PER MANUF. REQUIREMENTS

ROOF HATCH
1 1/2" = 1'-0"


33

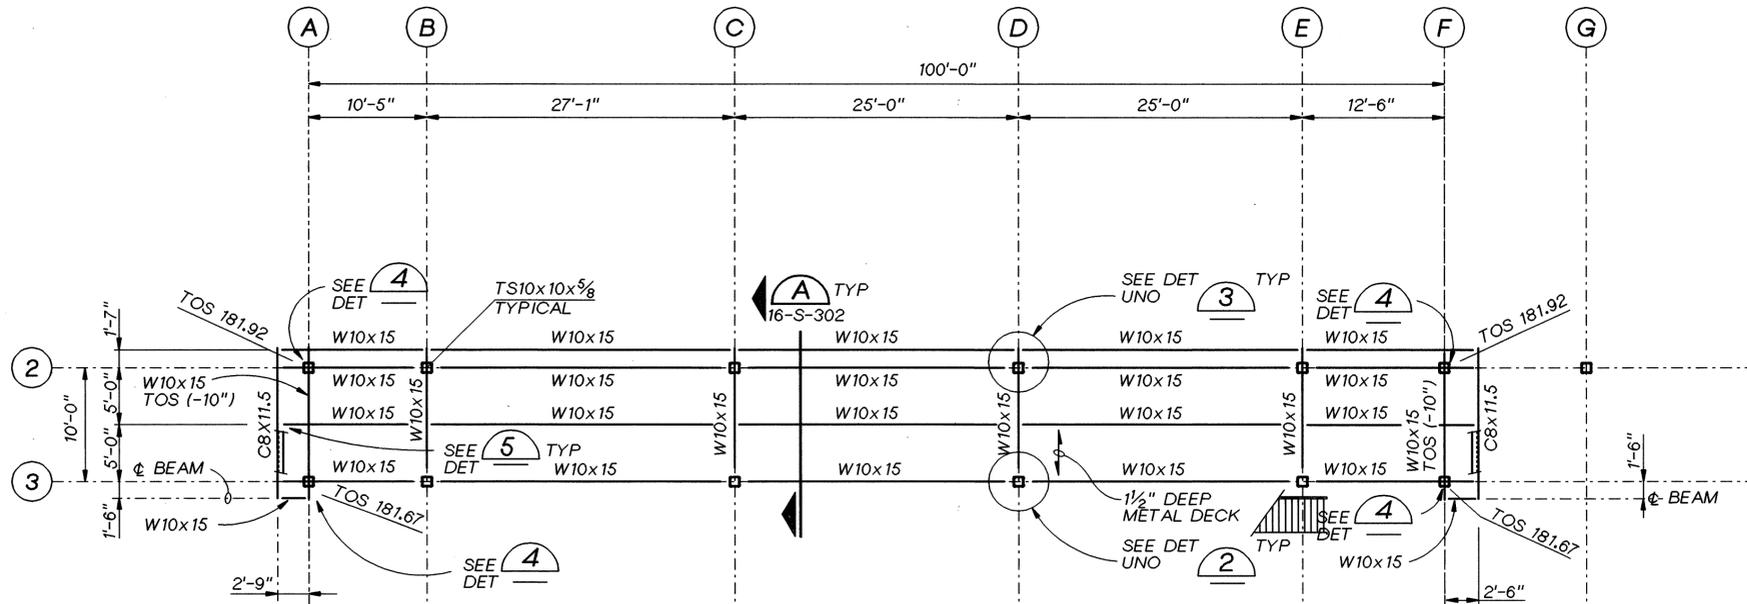


UPPER ROOF FRAMING PLAN
1/8"=1'-0"

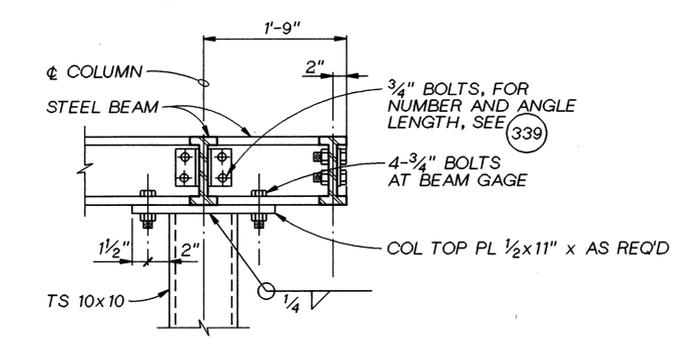

BEAM COLUMN CONNECTION (3)
NTS

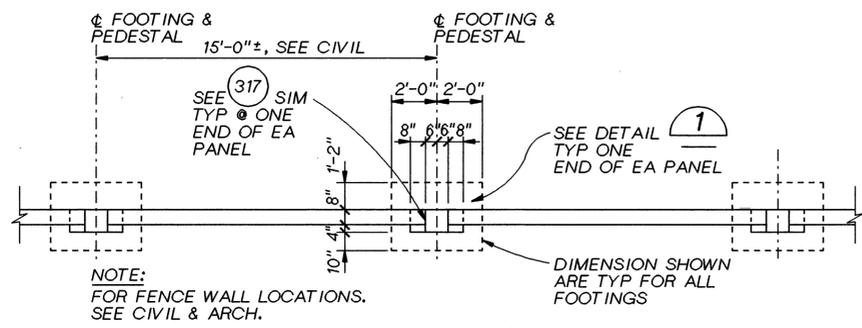

FENCE WALL PARTIAL PLAN
1/4"=1'-0"


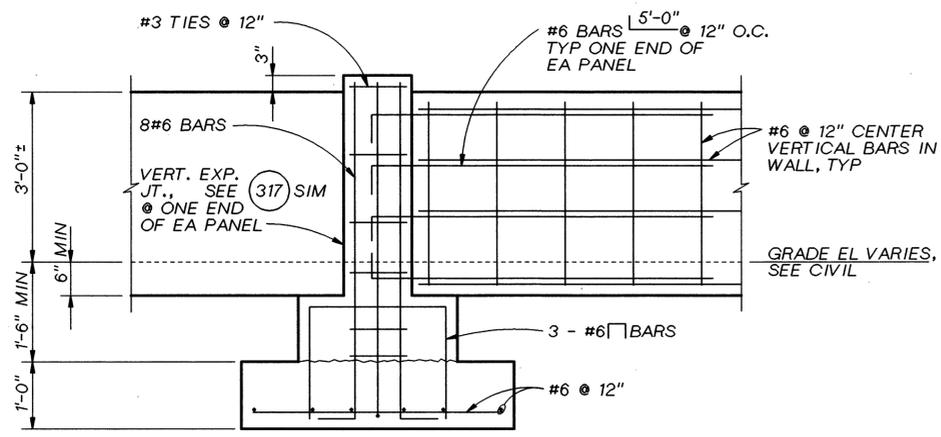


FENCE WALL DETAIL (1)
3/4"=1'-0"


GENERAL NOTES:
1. SEE 16-S-103 FOR ROOF DECK NOTES.

RECORD DRAWINGS


Revisions Drawn By ER BROWN Date JUNE 1995
THESE RECORD DRAWINGS HAVE BEEN PREPARED, IN PART, ON THE BASIS OF INFORMATION COMPILED BY OTHERS. THEY ARE NOT INTENDED TO REPRESENT IN DETAIL THE EXACT LOCATION, TYPE OF COMPONENT NOR MANNER OF CONSTRUCTION. THE ENGINEER WILL NOT BE RESPONSIBLE FOR ANY ERRORS OR OMISSIONS WHICH HAVE BEEN INCORPORATED INTO THE RECORD DRAWINGS.

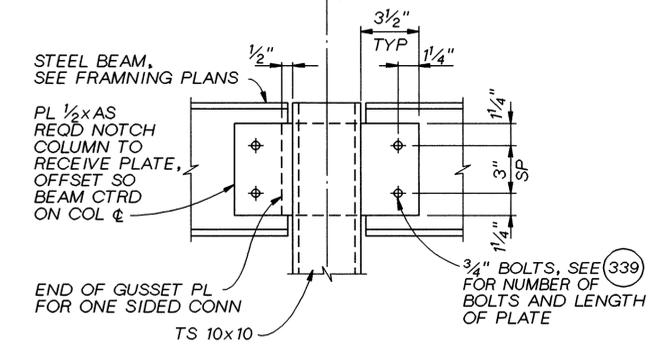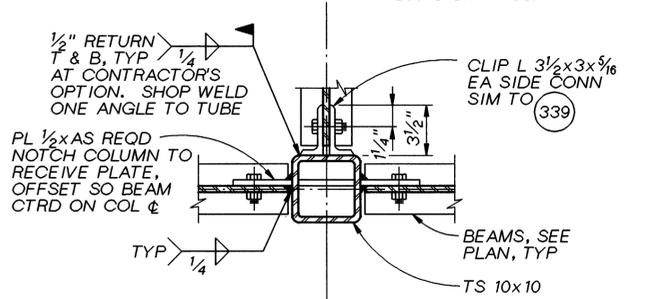

CONT TUBE COLUMN - BEAM CONN (2)
NTS

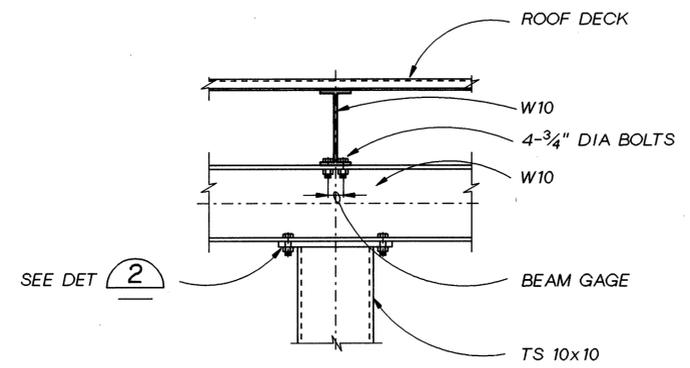

DETAIL (4)
NTS

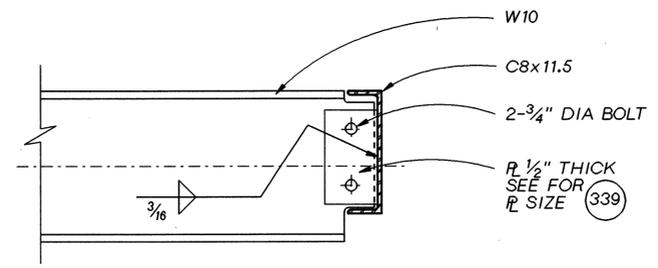

DETAIL (5)
NTS

THE ORIGINAL DRAWING WAS STAMPED BY BASSAM J. MOUSSAN OREGON P.E. NO. 15516

DSGN	BJ MOUSSAN
DR	MA WILLS R416S131.DGN
CHK	SM PITKIN
APVD	RM BRACKEN

NO.	DATE	REVISION
	06-95	RECORD DRAWING

REUSE OF DOCUMENTS
THIS DOCUMENT, AND THE IDEAS AND DESIGNS INCORPORATED HEREIN, AS AN INSTRUMENT OF PROFESSIONAL SERVICE, IS THE PROPERTY OF CH2M HILL AND IS NOT TO BE USED, IN WHOLE OR IN PART, FOR ANY OTHER PROJECT WITHOUT THE WRITTEN AUTHORIZATION OF CH2M HILL.

IF NOT ONE INCH ON THIS SHEET, ADJUST SCALES ACCORDINGLY.

ROCK CREEK FACILITY
UNIFIED SEWERAGE AGENCY
WASHINGTON COUNTY, OREGON

PHASE 4 EXPANSION - SOLIDS PROCESSING ADMINISTRATION BUILDING
STRUCTURAL UPPER ROOF FRAMING PLAN

SHEET	655
DWG NO.	16-S-104
DATE	DEC 1991
PROJ NO.	PDX21262.W1